Project Ref	3260 Ballymastone Phase 3
Client:	Glenveagh Homes Ltd
Block Ref	Block 7
Date:	Sept-25
Revision	00

Sectional Water Tank - Sprinkler
Capacity - 9600L
Size - 2 x 2 x 2.4 (L x W X H)
Weight - 11063 kg
500mm clearence around & 750mm clearence on top of the Tank

Note: Plant room of approx 60m2 is required close to the sprinkler tank

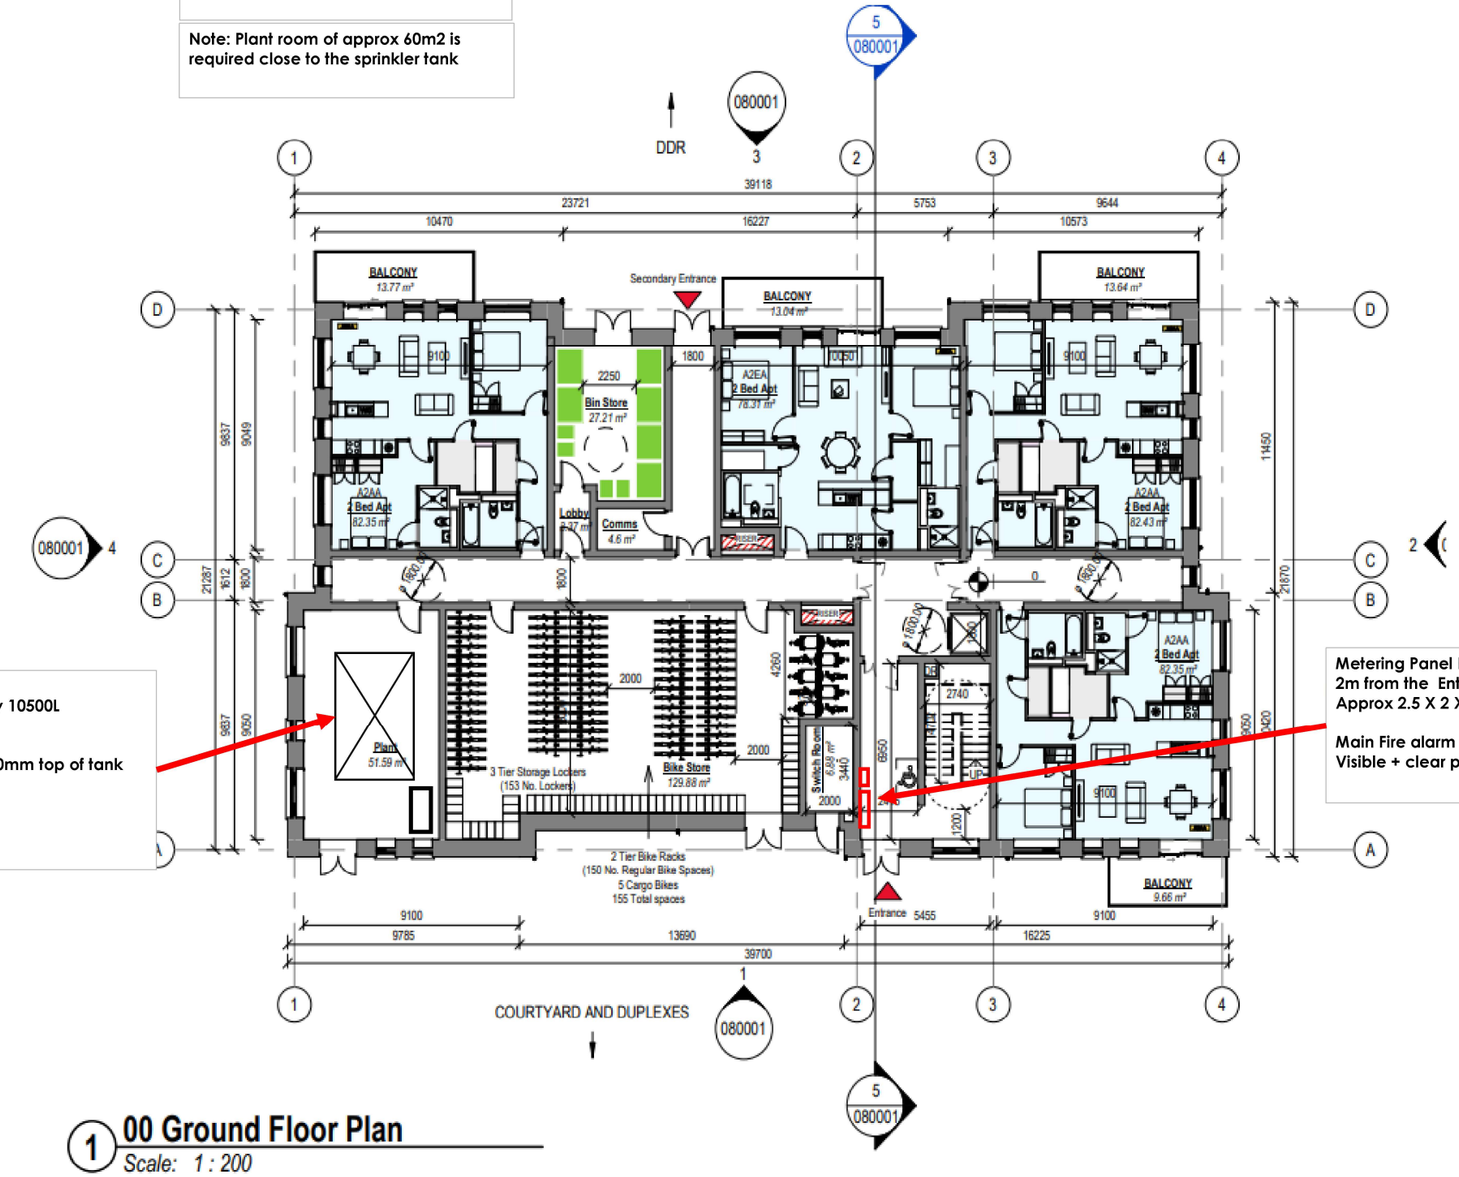

Block 7
Water Tank Sectional - Capacity 10500L
Size 3x2x1.75m (LxWxH)
Weight - 11100L
500mm Clearence around & 750mm top of tank
+Pumpset to be located here

Metering Panel Block 07
2m from the Entrance
Approx 2.5 X 2 X 2.6m

Main Fire alarm panel - Block 7
Visible + clear panel

1 00 Ground Floor Plan

Scale: 1 : 200

Project Ref	3260 Ballymastone Phase 3
Client:	Glenveagh Homes Ltd
Block Ref	Block 8
Date:	Sept-25
Revision	00

Block 8
Water Tank Sectional - Capacity 13000L
Size 3x2.5x1.75m (LxWxH)
Weight - 13600L
500mm Clearence around & 750mm top of tank
+Pumpset to be located here

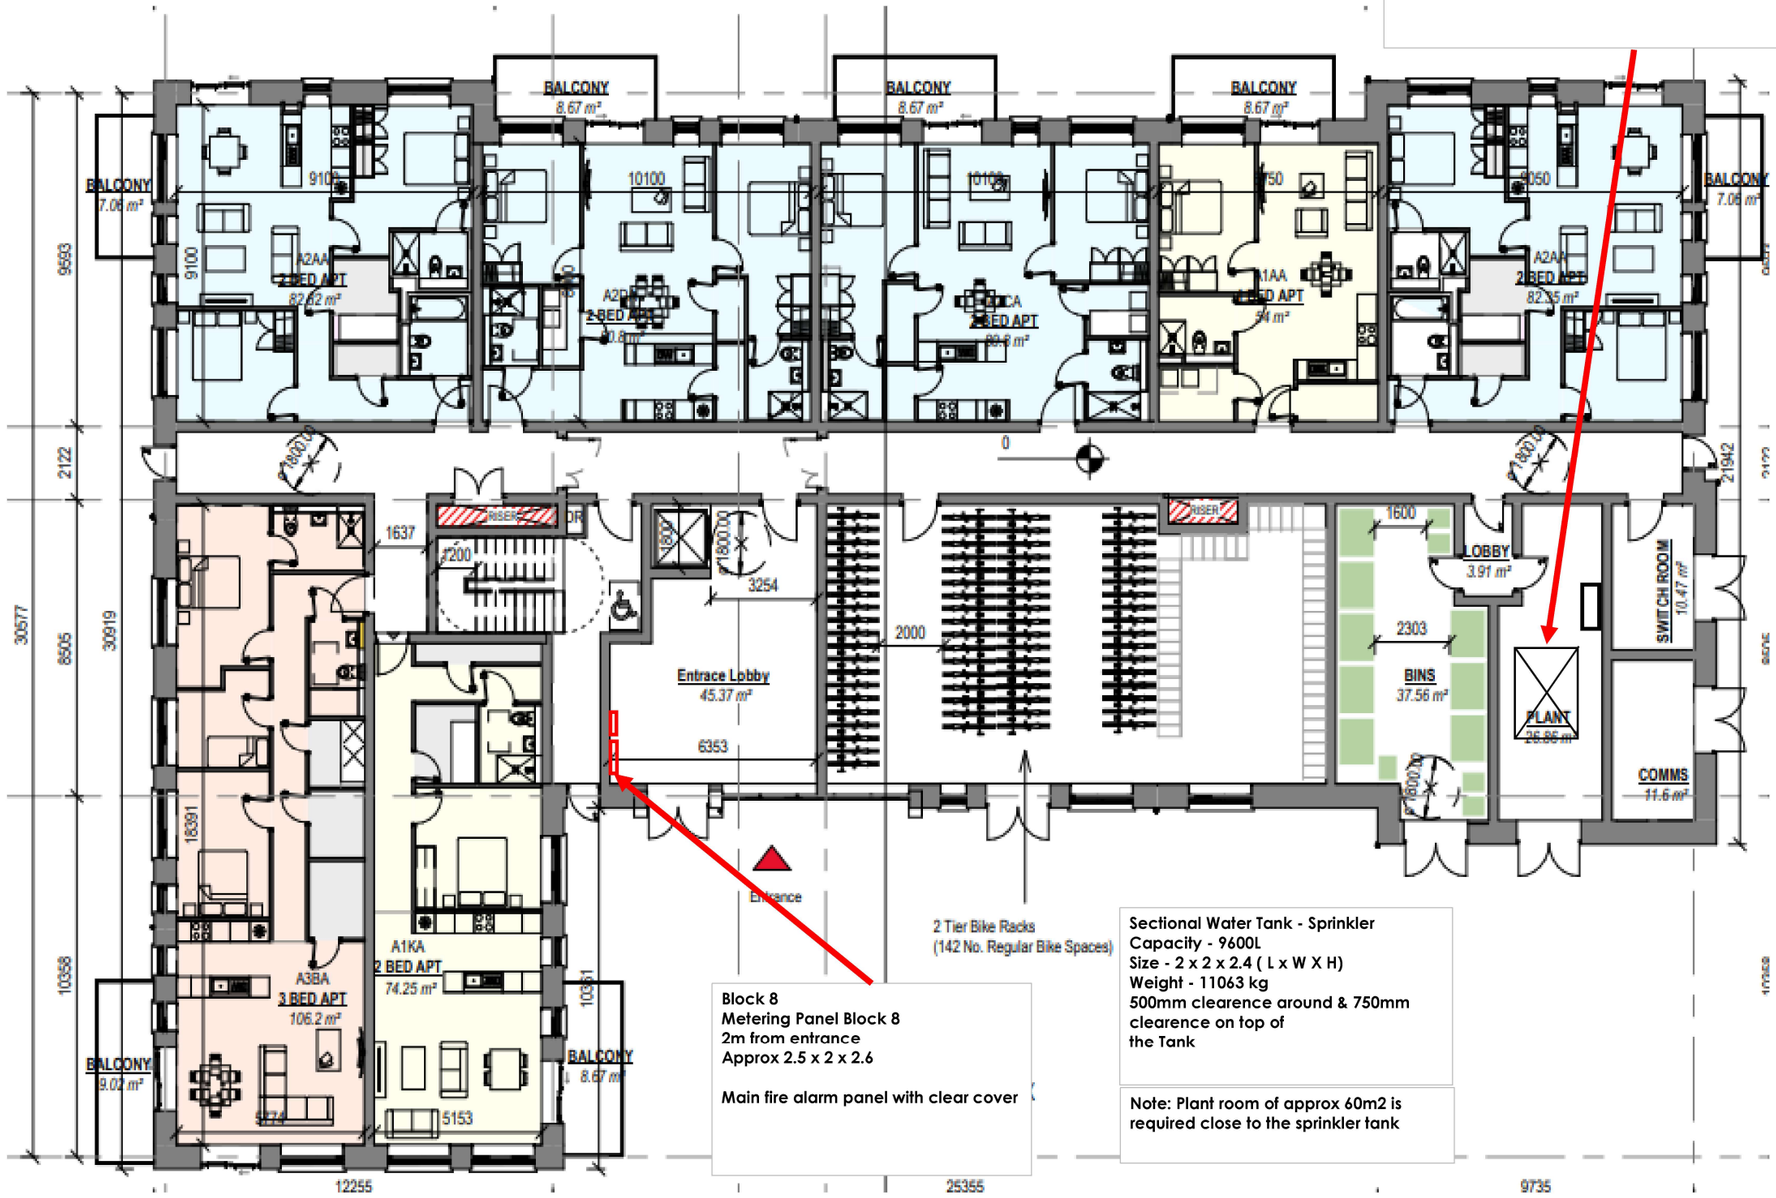

Block 8
Metering Panel Block 8
2m from entrance
Approx 2.5 x 2 x 2.6

Main fire alarm panel with clear cover

Sectional Water Tank - Sprinkler
Capacity - 9600L
Size - 2 x 2 x 2.4 (L x W X H)
Weight - 11063 kg
500mm clearence around & 750mm clearence on top of the Tank

Note: Plant room of approx 60m2 is required close to the sprinkler tank
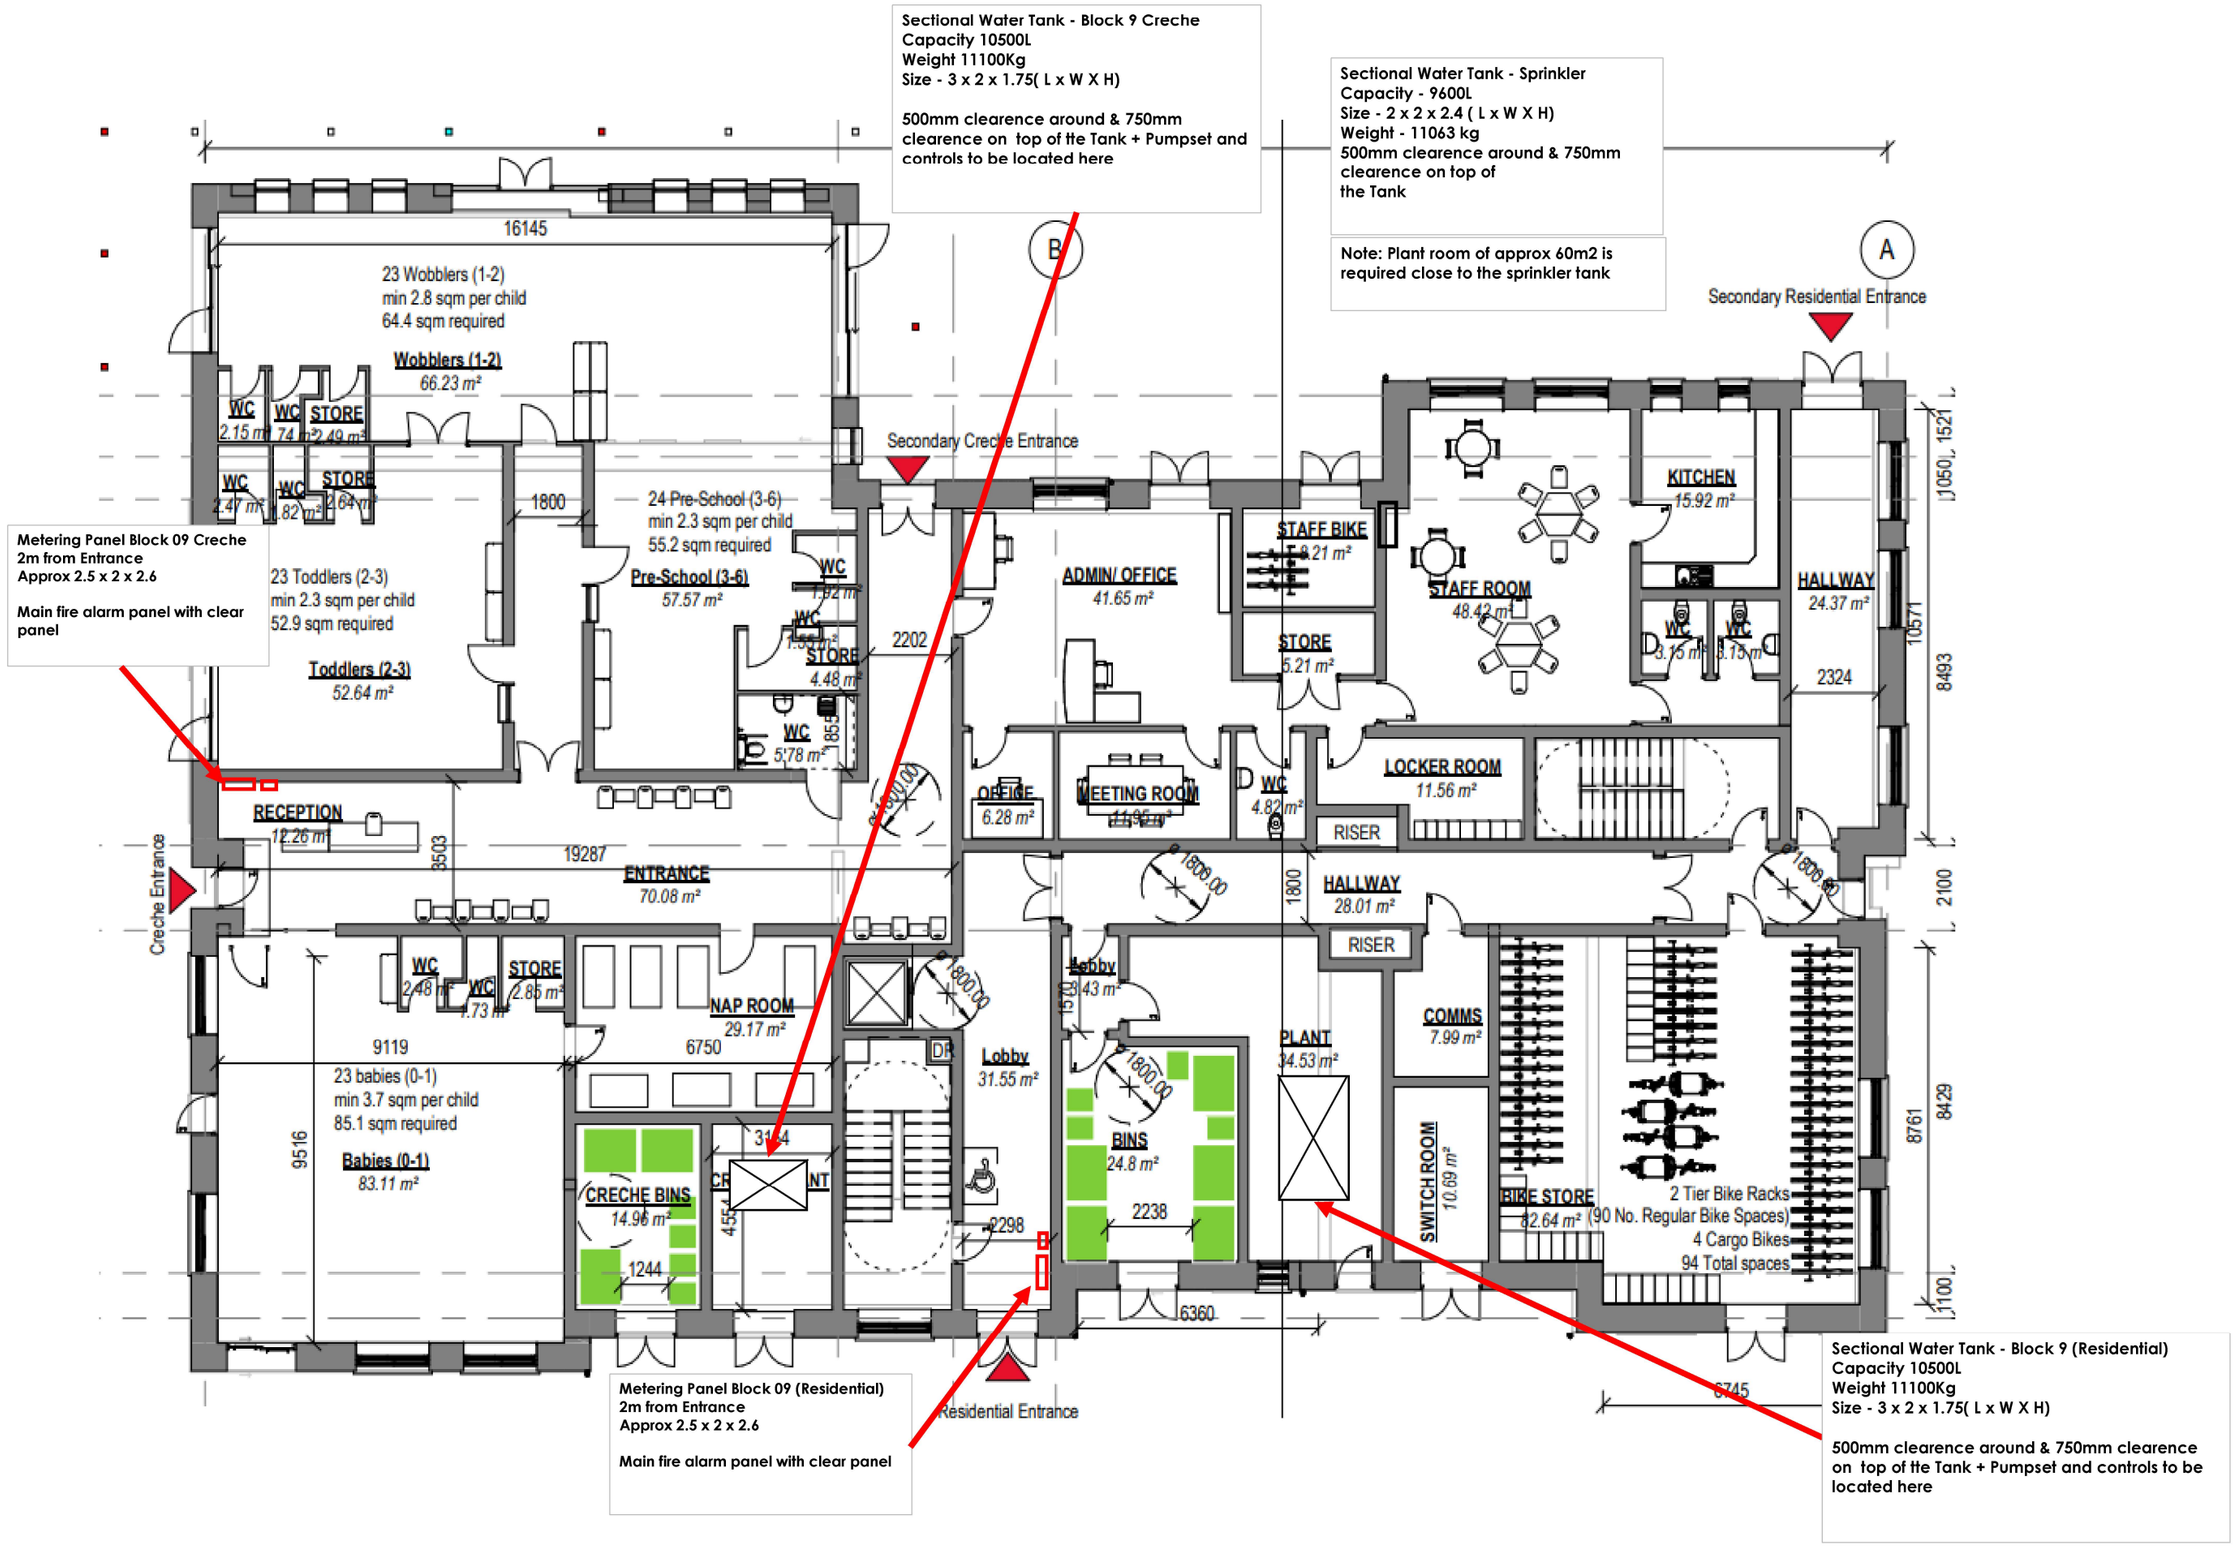
Project Ref	3260 Ballymastone Phase 3
Client:	Glenveagh Homes Ltd
Block Ref	Block 9
Date:	Sept-25
Revision	00